



TOWNSHIP OF ABINGTON


Wastewater Department

To: Richard J. Manfredi, Township Manager
From: George Wrigley, Director
Date: November 21, 2019
Subject: Act 537 Special Study - Cheltenham Township Asset Sale -review

Project: Aqua Pa purchase of the sanitary sewer system from Cheltenham Township
Project Address: Cheltenham Township
Applicant's consultant: Brown & Caldwell

I reviewed the document titled "Act 537 Special Study - Cheltenham Township Asset Sale" dated October 8, 2019 as it relates to the Township of Abington. The text in the study that speaks to the various Abington related aspects of the sanitary sewer system(s) that discharge into the Cheltenham Township sanitary sewer system for conveyance to Philadelphia Water Department was described satisfactorily. The comment I have relates to Figure 2-2 "Sewer Service Area (Source Act 537, 2014)": A portion of the sewer service area associated with our Cardinal Pump Station (located on Township Line Road between Meetinghouse Road and Cardinal Road) is not included in the Cheltenham Township Sewer Service Area. The Cardinal Pump Station was constructed in 1967 to divert sanitary sewer flows away from Cheltenham Township to the Philadelphia Water Department collection system. Figure 2-2 should be revised to exclude the Cardinal Pump Station drainage area (Gordon Road, Lenox Road, Cardinal Road, Squirrel Road, Sparrow Road, Woodpecker Road, Westbury Road, Wellington Terrace, Sunset Avenue, Meetinghouse Road - Township Line Road to Jenkintown Road and Old York Road - Township Line Road to Wyncote Avenue) See attached Figure 1.

FIGURE 1

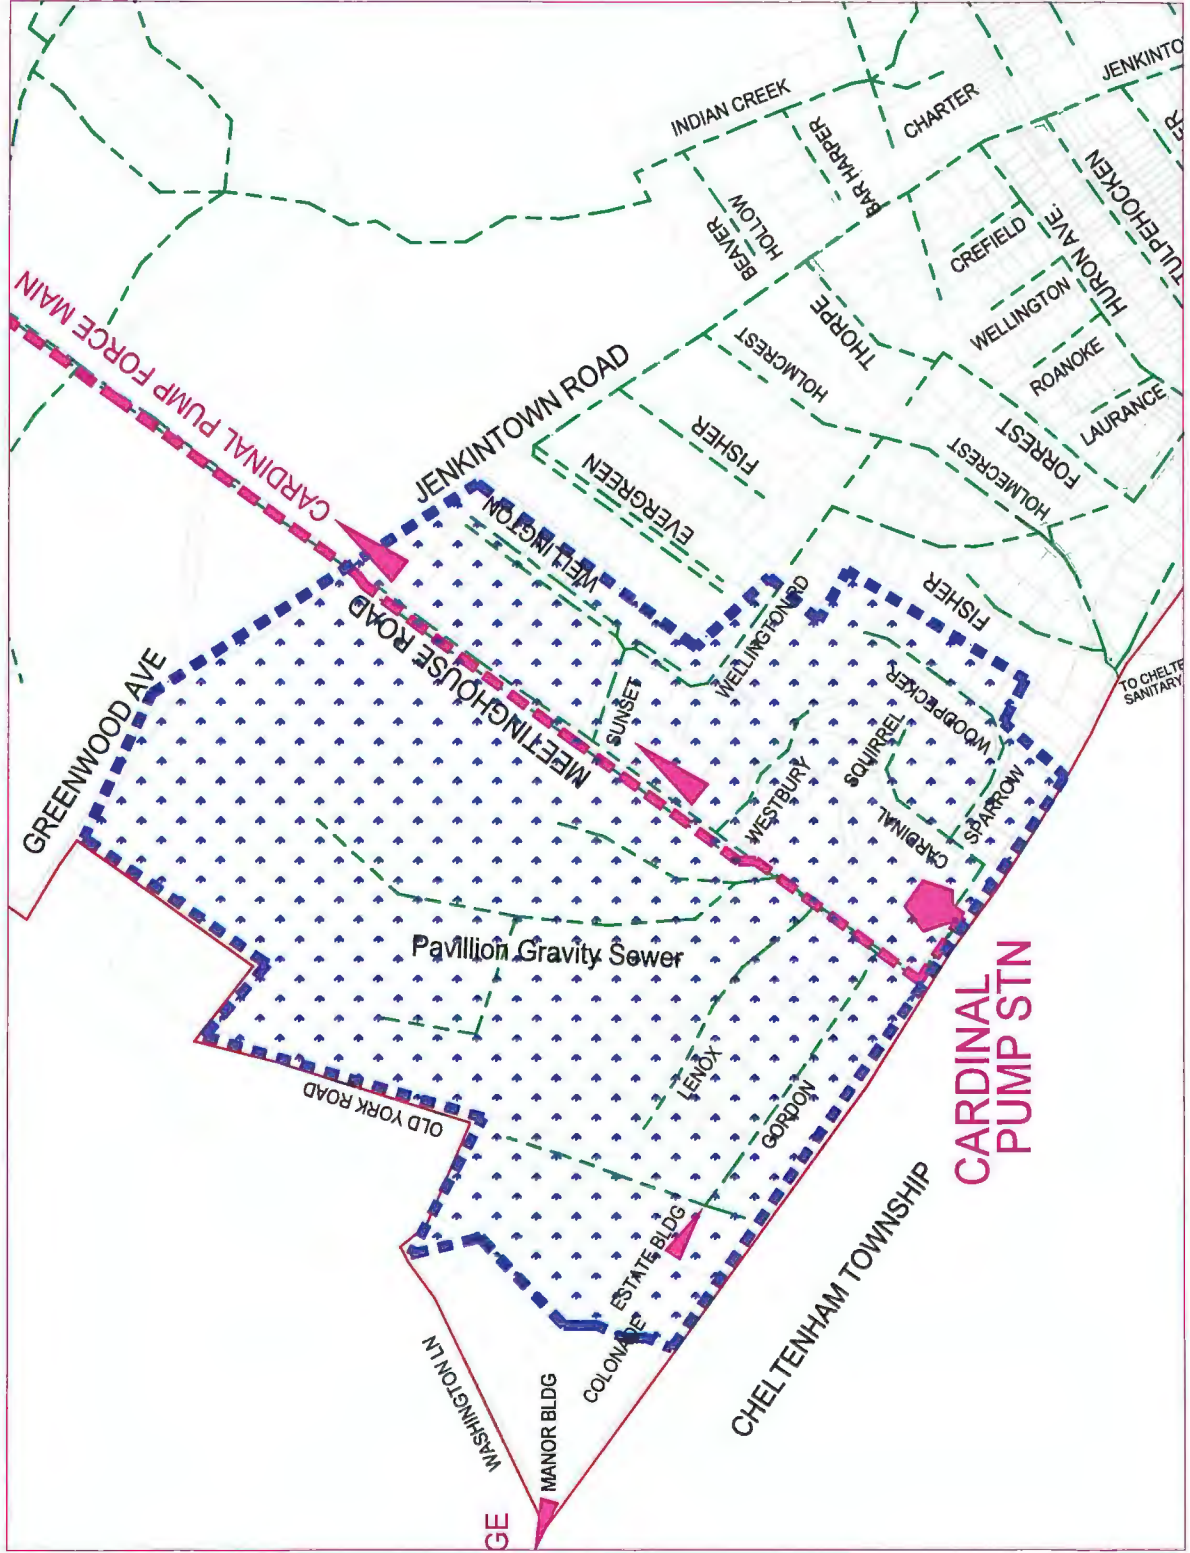

ABINGTON TOWNSHIP, MONTGOMERY COUNTY
CARDINAL PUMP STATION DRAINAGE AREA